


MSL ELEVATION AS SURVEYED ON THE FOLLOWING DATES

MONITOR POINT	DESCRIPTION	1999-2000	1/30/2002	12/05/2002	2003	2004	2005
0+00	CENTERLINE SKIWAY	9282.13					
10+00	CENTERLINE SKIWAY	9278.6	9280.2	9281.06			
20+00	CENTERLINE SKIWAY	9278.0	9279.5	9280.48			
30+00	CENTERLINE SKIWAY	9277.7	9279.2	9279.95			
40+00	CENTERLINE SKIWAY	9278.3	9279.5	9280.25			
50+00	CENTERLINE SKIWAY	9279.4	9280.8	9281.46			
60+00	CENTERLINE SKIWAY	9281.4	9283.4	9283.71			
70+00	CENTERLINE SKIWAY	9283.1	9284.2	9285.14			
80+00	CENTERLINE SKIWAY	9285.9	9287.9	9288.74			
90+00	CENTERLINE SKIWAY	9290.9	9292.3	9293.12			
100+00	CENTERLINE SKIWAY	9294.6	9295.8	9296.36			
110+00	CENTERLINE SKIWAY	9296.7	9298.2	9298.99			
120+00	CENTERLINE SKIWAY	9298.9	9300.7	9301.16			
130+00	CENTERLINE SKIWAY	9300.5	9302.2	9302.85			
140+00	CENTERLINE SKIWAY	9302.6	9305.0	9305.21			


NOTES

1. THIS DRAWING IS USED IN CONJUNCTION WITH THE S.O.P. ENTITLED, SOUTH POLE STATION ANNUAL SURVEY AND FACILITY LEVELING.

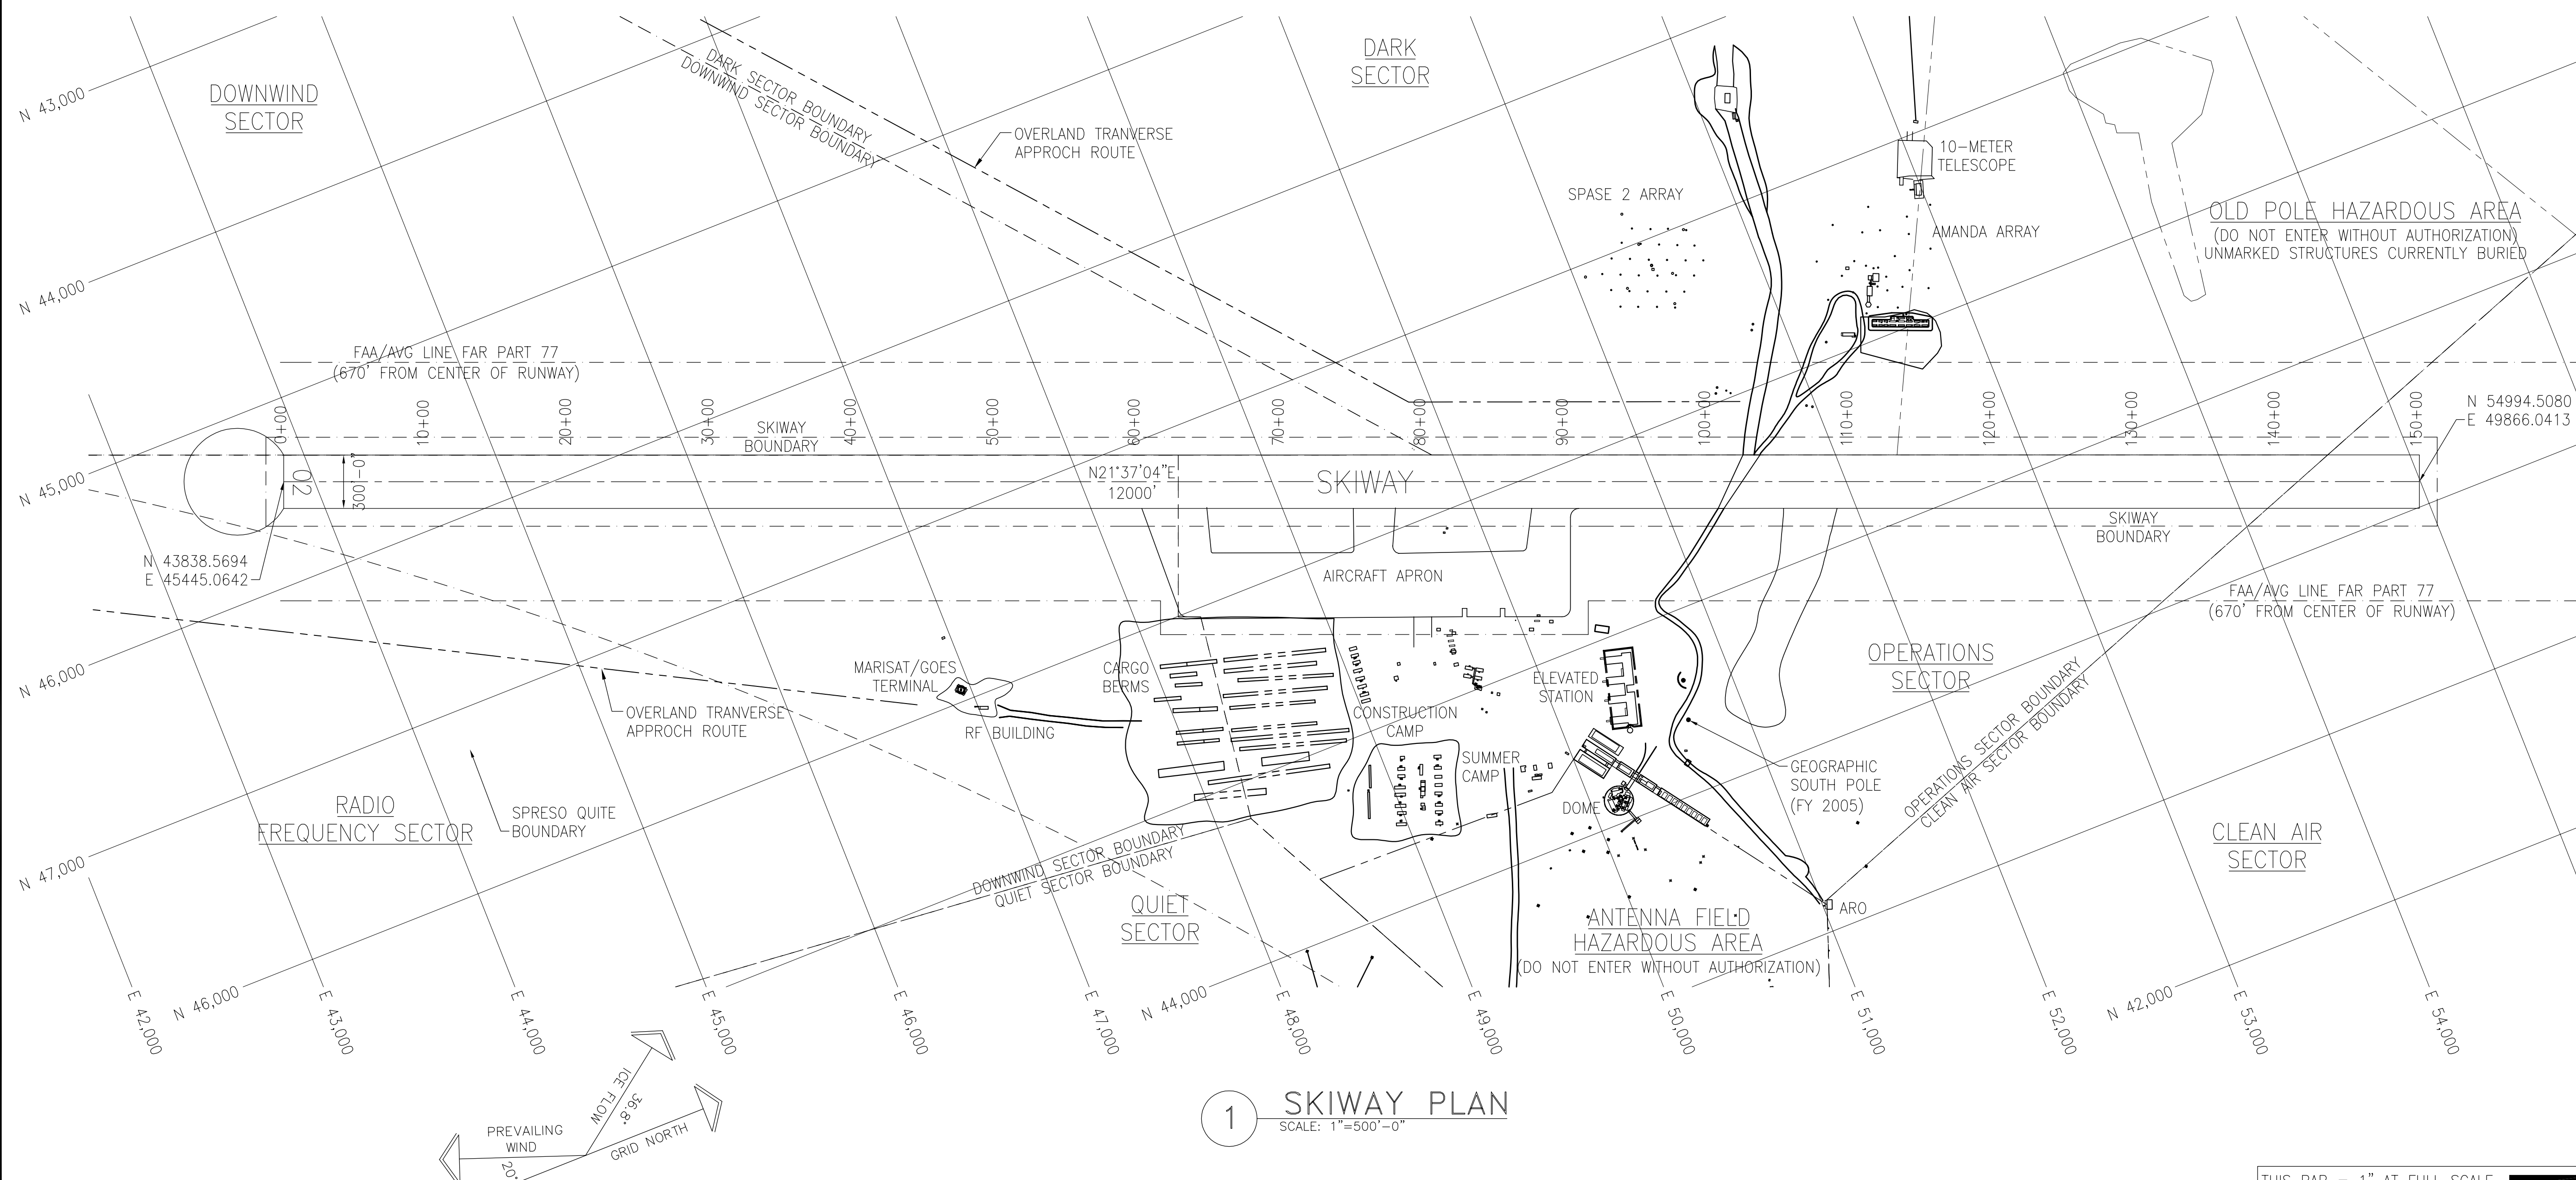

1 SKIWAY PLAN
SCALE: 1"=500'-0"

THIS BAR = 1" AT FULL SCALE

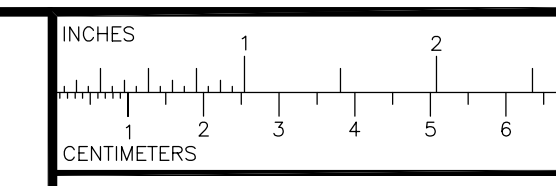

NATIONAL SCIENCE FOUNDATION
OFFICE OF POLAR PROGRAMS
WASHINGTON, D.C. NSF
CONTRACT OPP. 0000373

REV. NO.	DATE	REVISIONS	DESIGNED BY	CHECKED BY
1	10/4/05	2004-2005 AS-BUILTS	RJT	CW

SOUTH POLE STATION AS-BUILTS
OPERATIONS SECTOR
CIVIL

DATE CREATED: 12/17/2004
DRAWN BY: RJT
DESIGNED BY: RJT
CHECKED BY: CW

7400 South Tucson Way
Centennial, Colorado
80112-3938 USA
303-790-8606
303-790-9130
303-790-9130 Fax

Raytheon
Polar Services

FILE NAME: SP-SSP-C-129-REV1
PROJECT NUMBER:
SCALE: AS NOTED
SHEET TITLE: SKIWAY SURVEY/DATA RECORD
SHEET NUMBER: SP-SSP-C-129