IF SHEET IS NOT 34"x22", THEN USE GRAPHIC SCALE

INCHES 1 2
CENTIMETERS 1 2 3 4 5 6

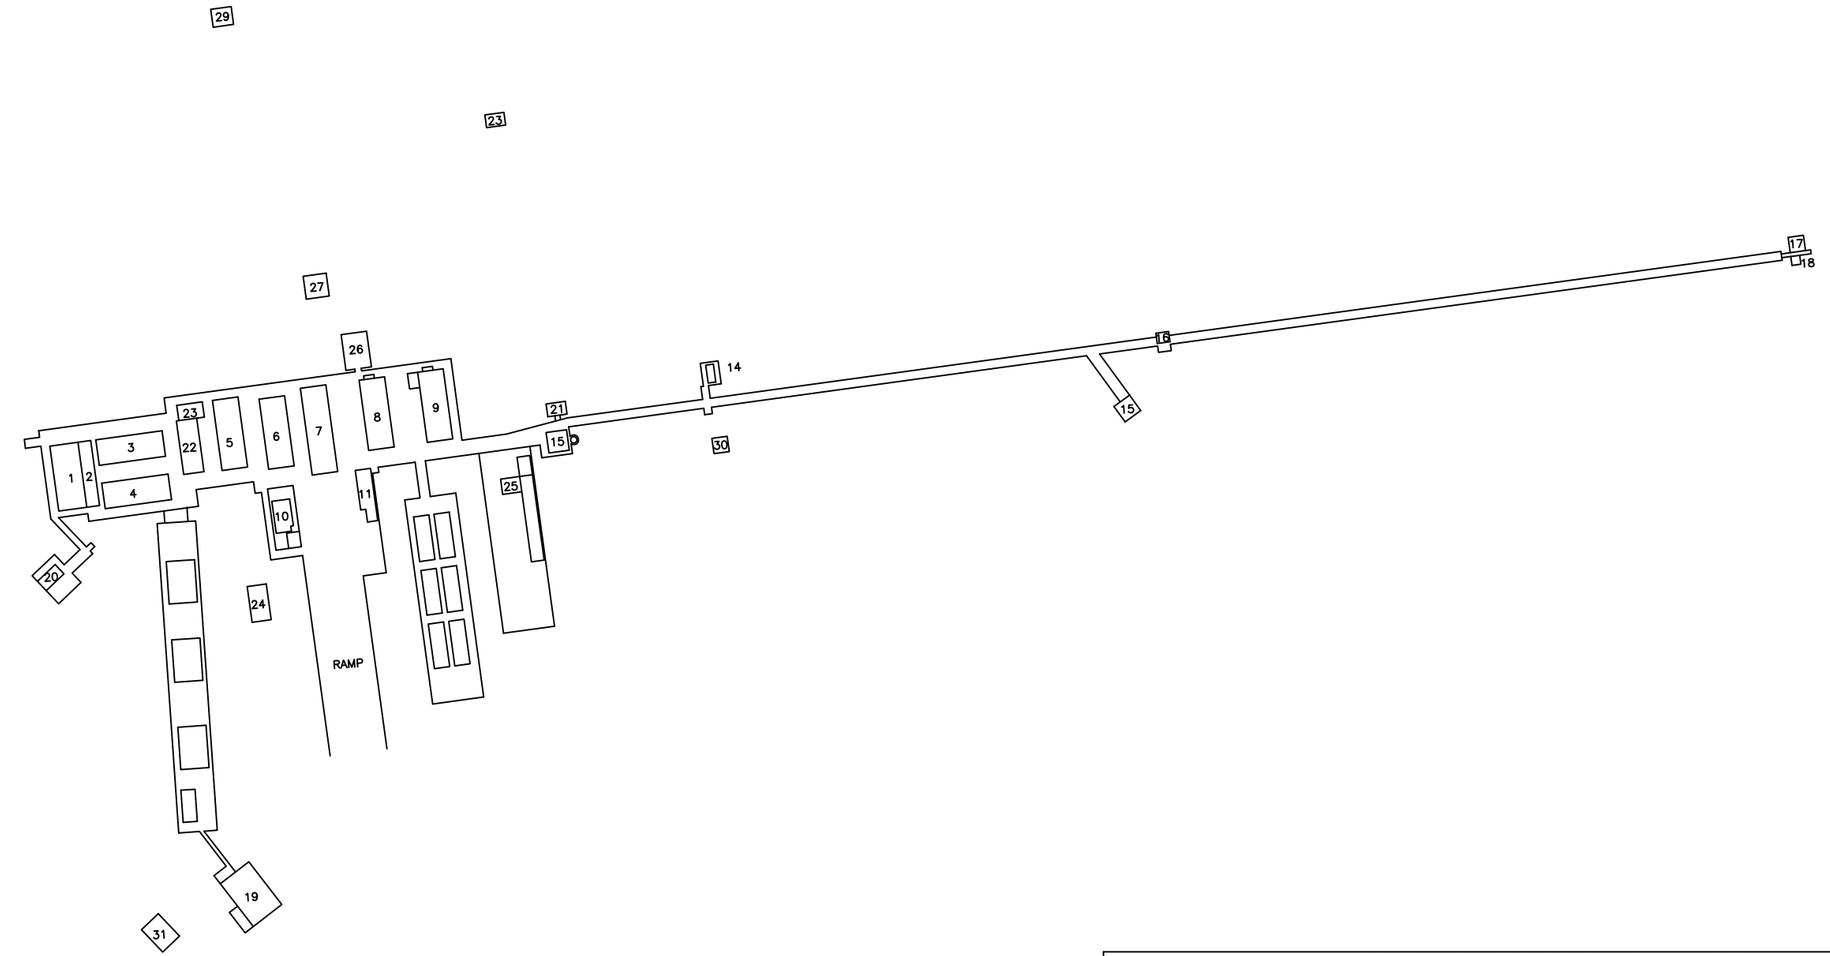

DOME AND ARCHES BUILDING INDEX					
1	COMMUNICATIONS	17	SEISMETIC VAULT	17	SEISMETIC VAULT
2	HAM SHACK/MEMO ROOM/LIBRARY	18	SEISMOLOGY RECORDING	18	
3	DISPENSARY	19	GARAGE SHOPS		
4	ASA QUARTERS	20	EMERGENCY		
5	MESS HALL AND WEATHER SHACK	21	WEATHER BUREAU STORAGE		
6	CLUB 90°	22	OJC & AOIC OFFICES/SHIP STORE		
7	P.W. SHOPS/PHOTO LAB/STEAM BATH	23	HEAD		
8	USARP QUARTERS	24	DIESEL/ELECTRICAL POWER PLANT		
9	SCIENCE BLDG./WORK SHOP	25	SUPPLY/PARKING & BERTHING AREA		
10	REC. ROOM/CE SHOP/MAIN BREAKER	26	SNOW MELTER		
11	ASA BERTHING AREA	27	TEMPORARY MELTER GARAGE		
12	EMERGENCY HEAD	28	COS RAY		
13	BIT/HYDROGEN/GEN BLDG	29	VLF		
14	GRAVITY LAB	30	DOBSON HOUSE		
15	MAGNETIC VARIATIONS	31	TEMPORARY GARAGE		
16	MAGNETIC ABSOLUTES				

NATIONAL SCIENCE FOUNDATION
OFFICE OF POLAR PROGRAMS
WASHINGTON, D.C. NSF
CONTRACT OPP. 00003573

REVISIONS

REV NO	DATE

REV	DATE
REVIEWED	

REVISION APPROVAL RECORD

DISCIPLINE	REVIEWED	DISCIPLINE	DATE
ARCHITECTURAL		CIVIL	
CONSTRUCTION		ELECTRICAL	
ENVIRONMENTAL		FIRE DETECT	
FIRE SUPPRESS.		INFO. SYS.	
MAINTANCE		MECHANICAL	
H.S.F.		OPERATIONS	
Q.A.		SAFETY	
SCIENCE		STRUCTURAL	

SOUTH POLE STATION
OLD POLE STATION PLAN BASED ON 1971-72 PLANS & 97 AS-BUILT

DATE CREATED: MM/DD/YY
DRAWN BY: THOMPSON
CHECKED BY: C. WALKER

Raytheon
Raytheon Polar Services

DWG. NO. XXXXX
PRO. # XXXXX
SCALE: 1"=60'-0"
SHEET ORDER # OF #
SHEET NAME C-07

8 7 6 5 4 3 2 1
D C B A